


FOR REFERENCE SEE MAPS ENTITLED:

- 1) SITE PLAN - SUBDIVISION - 40 SCALE GRISWOLD FARMS (FORMERLY LIVINGSTON et al PROPERTY) OPEN SPACE SUBDIVISION AT WATER ROAD, CANTON, CONNECTICUT SCALE 1"=40' JULY 31, 2000 REVISED TO JANUARY 17, 2001 SHEETS 26 & 27 MILONE & MacBROOM 716 SOUTH MAIN STREET, CHESHIRE, CONNECTICUT 06410 ROBERT A. JACKSON, Jr. L.S.

NOTES:

- 1) PROPERTY LOCATED IN AR-2 OPEN SPACE.
- 2) THERE MAY BE AN EASEMENT FOR THE CONNECTICUT LIGHT & POWER COMPANY AS OF RECORD MAY APPEAR.

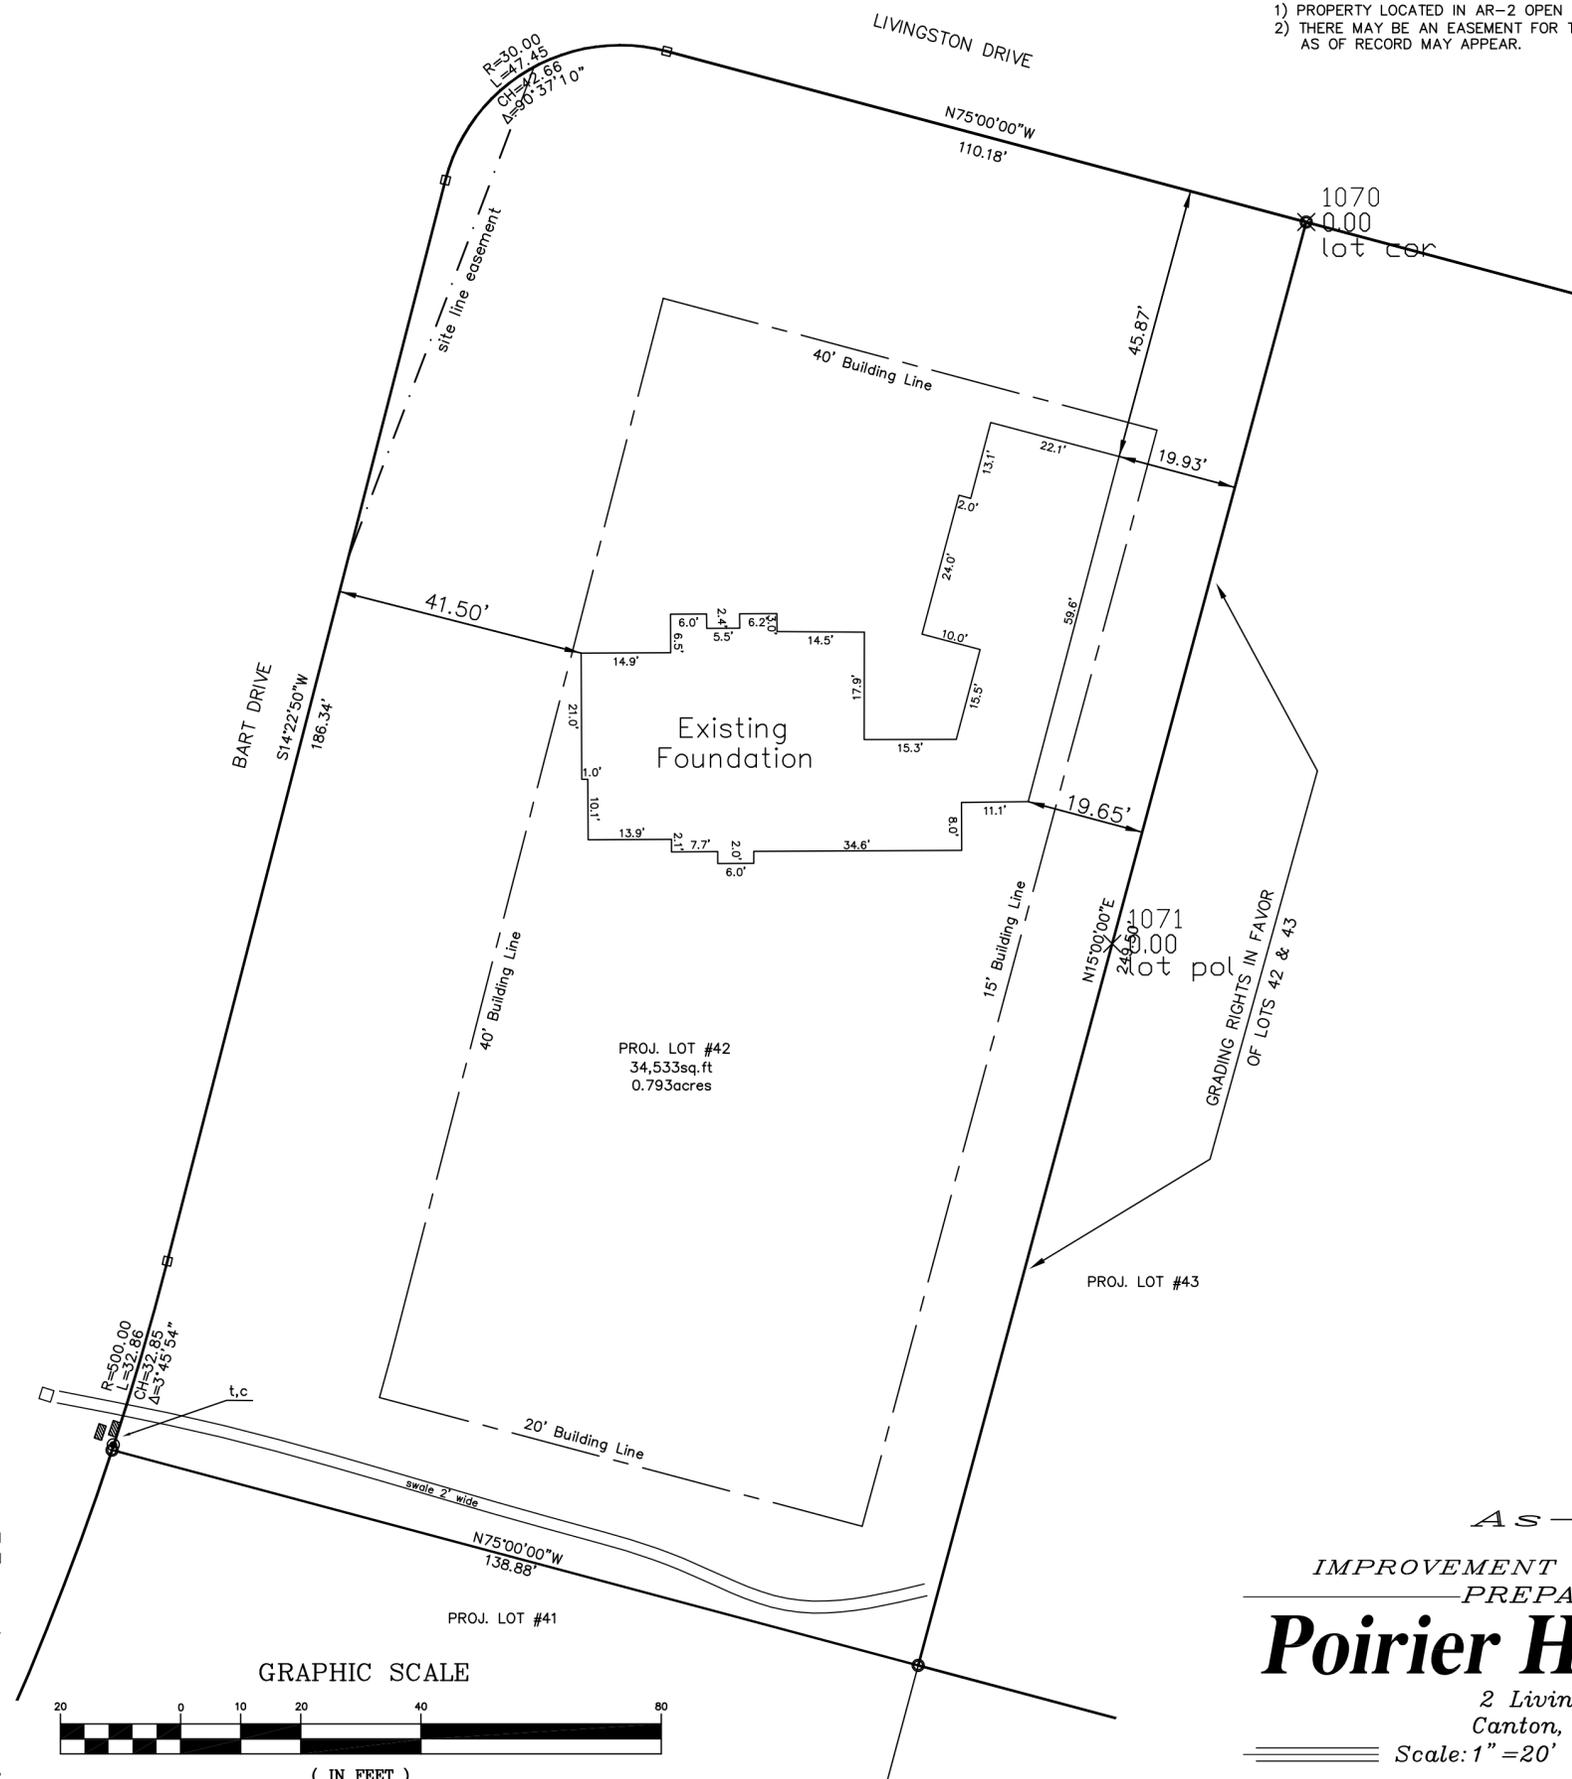

NOTE:
I HEREBY CERTIFY TO POIRIER HOMES, LLC AND FARMINGTON SAVINGS BANK THAT THE FOUNDATION LOCATED AS SHOWN ON JUNE 2, 2006, LOCATION DOES NOT VIOLATE THE ZONING ORDINANCE OF THE TOWN OF CANTON.


_____, SURVEYOR
HODGE SURVEYING ASSOCIATES, P.C.

NOTES AND DECLARATIONS
THIS SURVEY AND MAP HAS BEEN PREPARED IN ACCORDANCE WITH THE REGULATIONS OF CONNECTICUT STATE AGENCIES, SECTIONS 20-300b-1 THROUGH 20-300b-20, THE MINIMUM STANDARDS FOR SURVEYS AND MAPS IN THE STATE OF CONNECTICUT ENDORSED BY THE CONNECTICUT ASSOCIATION OF LAND SURVEYORS, INC. THE TYPE OF SURVEY IS PROPERTY SURVEY, THE BOUNDARY DETERMINATION CATEGORY IS RESURVEY AND THE HORIZONTAL ACCURACY CONFORMS TO A-2.

THIS IMPROVEMENT LOCATION MAP CONFORMS TO CLASS A-2 IN ACCORDANCE WITH THE MINIMUM STANDARDS FOR SURVEYS AND MAPS IN THE STATE OF CONNECTICUT AS ADOPTED FOR USE BY THE STATE OF CONNECTICUT ON SEPTEMBER 26, 1996.

TO MY KNOWLEDGE AND BELIEF THIS MAP IS SUBSTANTIALLY CORRECT AS NOTED HEREON.

_____, SURVEYOR
FRANCIS A. RICHARD, L.S. #11351

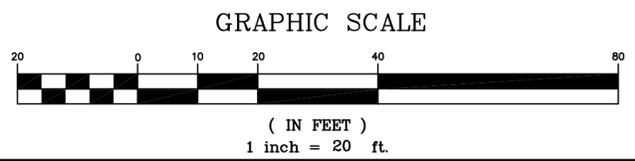

As-Built
IMPROVEMENT LOCATION SURVEY
PREPARED FOR
Poirier Homes LLC
2 Livingston Drive
Canton, Connecticut
Scale: 1" = 20' Date: June 2006
HODGE SURVEYING ASSOCIATES, P.C.

S:\Land Projects\2004\104-10.dwg\WORKSHEET.dwg, 2/19/2010 11:57:57 AM